

\*현장명 : 동래구신청사 #4,5 - 2(set)

LED BAR - 1500=8(EA)  
LED BAR - 200=8(EA)  
SMPS- (150W)=2(EA)

(등기구업체 - 다운텍)

특수타입

선길이-1.5M

AL PROFILE TUBE (마구리포함) - 238L

10000K=200L

SMPS  
150 W

10000K=200L

AL PROFILE TUBE (마구리포함) - 1546L

LED BAR-(누드&클립&잭타입)  
10000K = 1500L

10000K=500L

LED BAR-(누드&클립&잭타입)  
10000K = 1500L

AL PROFILE TUBE (마구리포함) - 1546L

10000K=500L



#2.3.

\*현장명 : 동래구신청사 ~~#2.3~~ - 2(set)

LED BAR - 1500=8(EA)  
LED BAR - 200=8(EA)  
SMPS - (150W)=2(EA)

(등기구업체 - 다운텍)

특수타입

선길이-1.5M

AL PROFILE TUBE (마구리포함) - 238L

10000K=200L

SMPS  
60 W

AL PROFILE TUBE (마구리포함) - 1546L

LED BAR-(누드&클립&잭타입)  
10000K = 1500L

10000K=500L

LED BAR-(누드&클립&잭타입)  
10000K = 1500L

AL PROFILE TUBE (마구리포함) - 1546L

10000K=200L


10000K=500L

12/11


2022.11.11

150W/60W

11/11

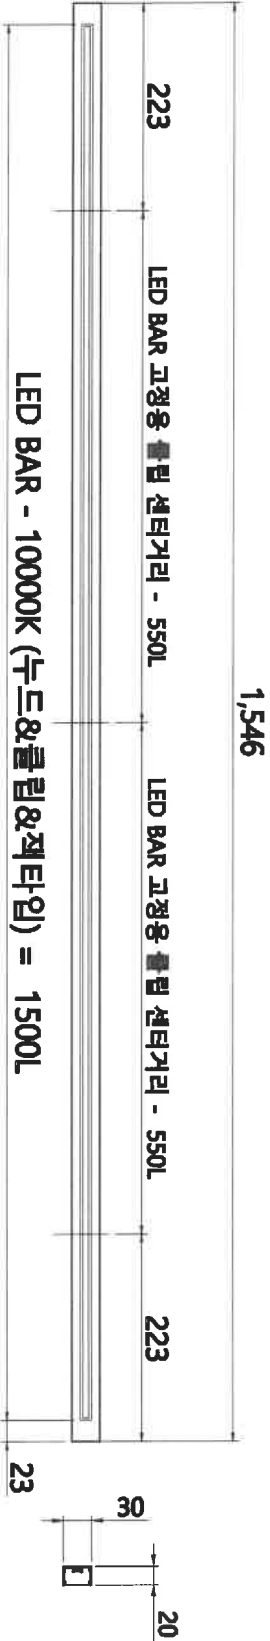

Part Name : PROFILE LED BAR 좌,우  
(확산커버포함)  
Mat.Spec : AL  
Size : SHP 3020 - 1546mm  
Quantity : 4 EA

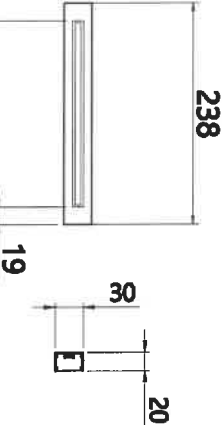

Part Name : PROFILE LED BAR 앞,뒤  
(확산커버포함)  
Mat.Spec : AL  
Size : SHP 3020 - 238mm  
Quantity : 4 EA


LED BAR-100000K(누드&클립&젝타입)=200L

△						TRACED BY	DRAWN BY	DESIGNED BY	CHECKED BY	REVIEWED BY	APPROVED BY	SCALE	1 / 5.5	PROJECT	동래구신청서 #2,3	
△												DATE	2024. 03. 14	DWG. NAME	-	
△												ANGLE		DWG. NO	MR-20240314-LC-06	SHEET
NO	DATE					REVISIONS	DEN	CHK	APR							0

\*. 현장명 : 동남-어린이대공원 - 1(set)

LED BAR - 1150=2(EA)  
SMPS- (60W)=1(EA)

(등기구업체 - 다운텍)

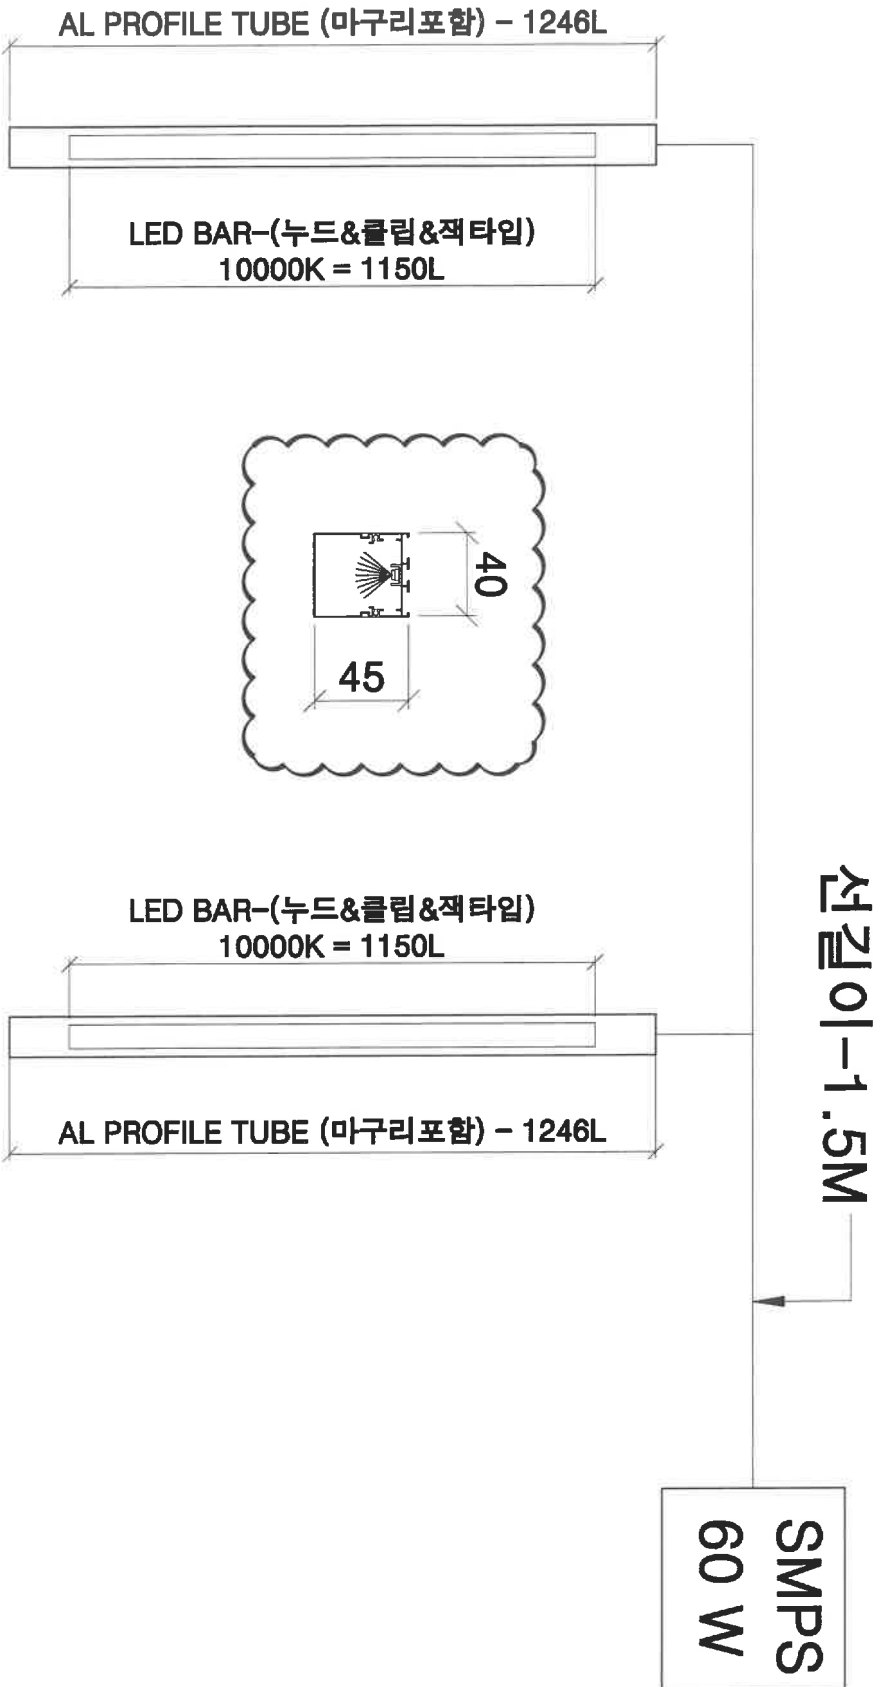




\*.현장명 : 삼라 마이다스빌 아파트 - 1(set)

LED BAR - 1400=1(EA)  
SMPS-1(EA)


LED BAR-~~10000K~~-1400L  
(누드&클립&양면테이프 타입)  
*6500K*  
*241K*

034타입

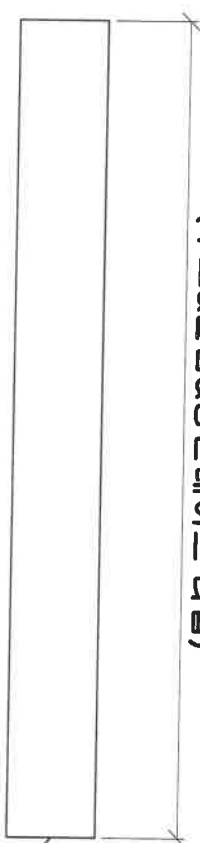


선길이-1M




SMPS

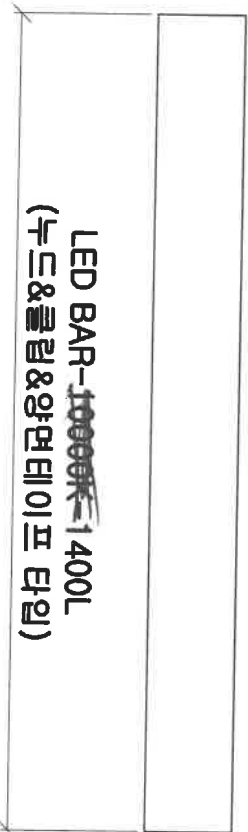

LED BAR-~~10000K~~-1400L  
(누드&클립&양면테이프 타입)

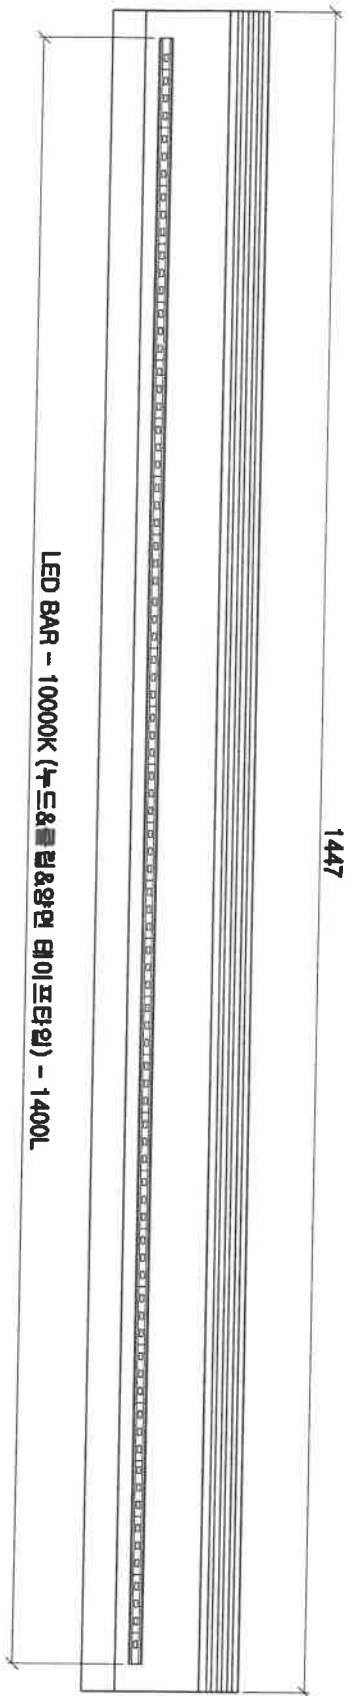

LED BAR - 10000K (누드&클립&양면 타이포타입) - 1400L

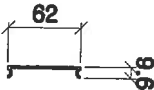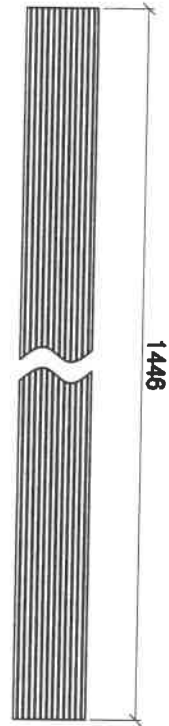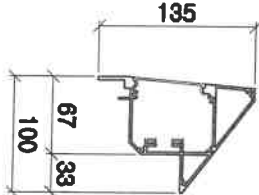

Part Name : LED 장착용 AL Profile  
Mat.Spec : AL  
Size : 135 x 100 x 1447mm  
Quantity : 2 EA

Part Name : 동기구커버  
Mat.Spec : PC  
Size : 1446 x 62mm  
Quantity : 2 EA



Part Name : COVER  
Mat.Spec : AL 1.5T  
Size : 135 x 132mm  
Quantity : 본도동일 2 EA  
본도반대 2 EA

△						TRACED BY	DRAWN BY	DESIGNED BY	CHECKED BY	REVIEWED BY	APPROVED BY	SCALE	1 / 8	PROJECT	삼라 마이 다스텔 아파트
△												DATE	2024. 07. 03	DWG. NAME	-
△												ANGLE		DWG. NO	MR-20240703-03
△															SHEET
NO	DATE					REVIEWS		DEV	CHEK	APR					0