


\*. 원장 : 거제시정밀관1동 - 1(set)  
          ~~거제시정밀관1동~~ - 1(set)

LED BAR - 1700=2(EA)  
SMPS-1(EA)

081X0007  
420 13/01/10

서글이-1M

7/22

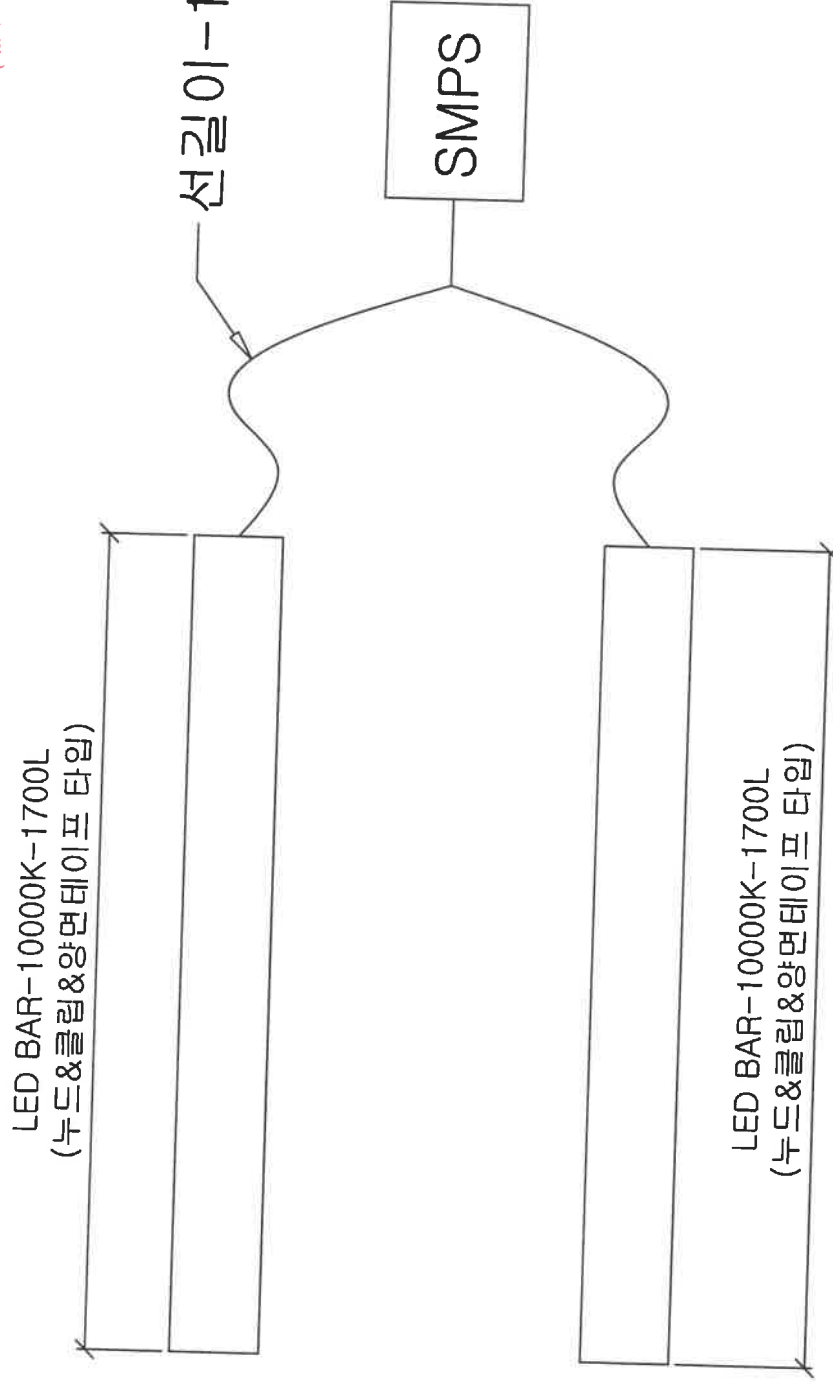

\*.현장명 : 세명엘리베이터-개운중학교/납기필 - 1(set)  
(등기구업체 : 다온텍)


LED BAR - 1350L=6(EA)

SMPS(100W)=2(EA)

031타입

(6108 e/c)

LED BAR-(누드&클립&잭타입)  
10000K-1350L

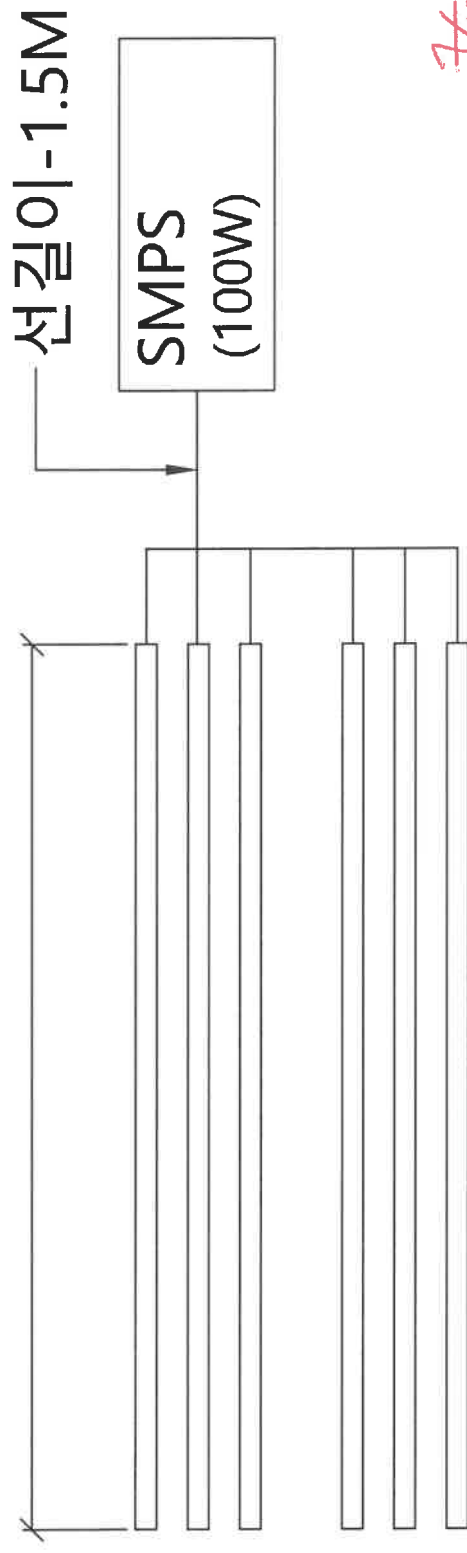

~~7/12~~

CAR INSIDE

W1630 x D1450

\*현장명 : 다와테크-LGS\_영양 인도어 골프장/납기필 - 1(set)

LED BAR-1450L=4(EA)  
SMPS(60W)=2(EA)

(등기구업체 : 다온텍)

N20타입

다와

선길이-1.5M

선길이-1.5M

SMPS  
(60W)

SMPS  
(60W)

LED BAR-(누드&클립&잭타입)  
10000K-1450L

LED BAR-(누드&클립&잭타입)

10000K-1450L

LED BAR-(누드&클립&잭타입)

10000K-1450L

LED BAR-(누드&클립&잭타입)

10000K-1450L

CAR INSIDE

W1800 x D1550

\*현장명 : 세명엘리베이터-보산초등학교/납기필 - 1(set)

LED BAR-1350L=4(EA)  
SMPS(60W)=2(EA)

(등기구업체 : 다온텍)

N20타입

(가공비)

선길이-1.5M

선길이-1.5M


SMPS  
(60W)

SMPS  
(60W)

LED BAR-(누드&클립&잭타입)  
10000K-1350L


LED BAR-(누드&클립&잭타입)

10000K-1350L

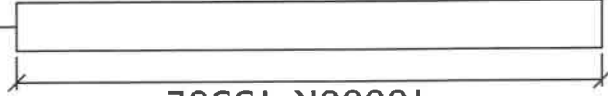


LED BAR-(누드&클립&잭타입)

10000K-1350L

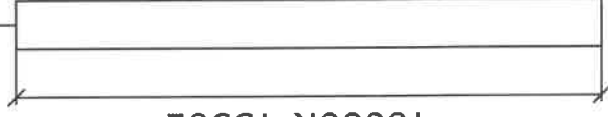

LED BAR-(누드&클립&잭타입)

10000K-1350L

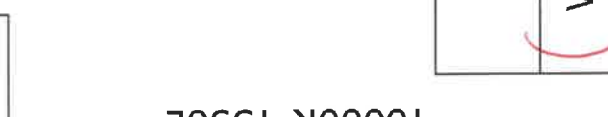


CAR INSIDE	
	W1600 x D1450


\* 현장명 : 세명엘리베이터-판곡초등학교/납기필 - 1(set)

075 4100 4100


(등기구업체 : 다운텍)

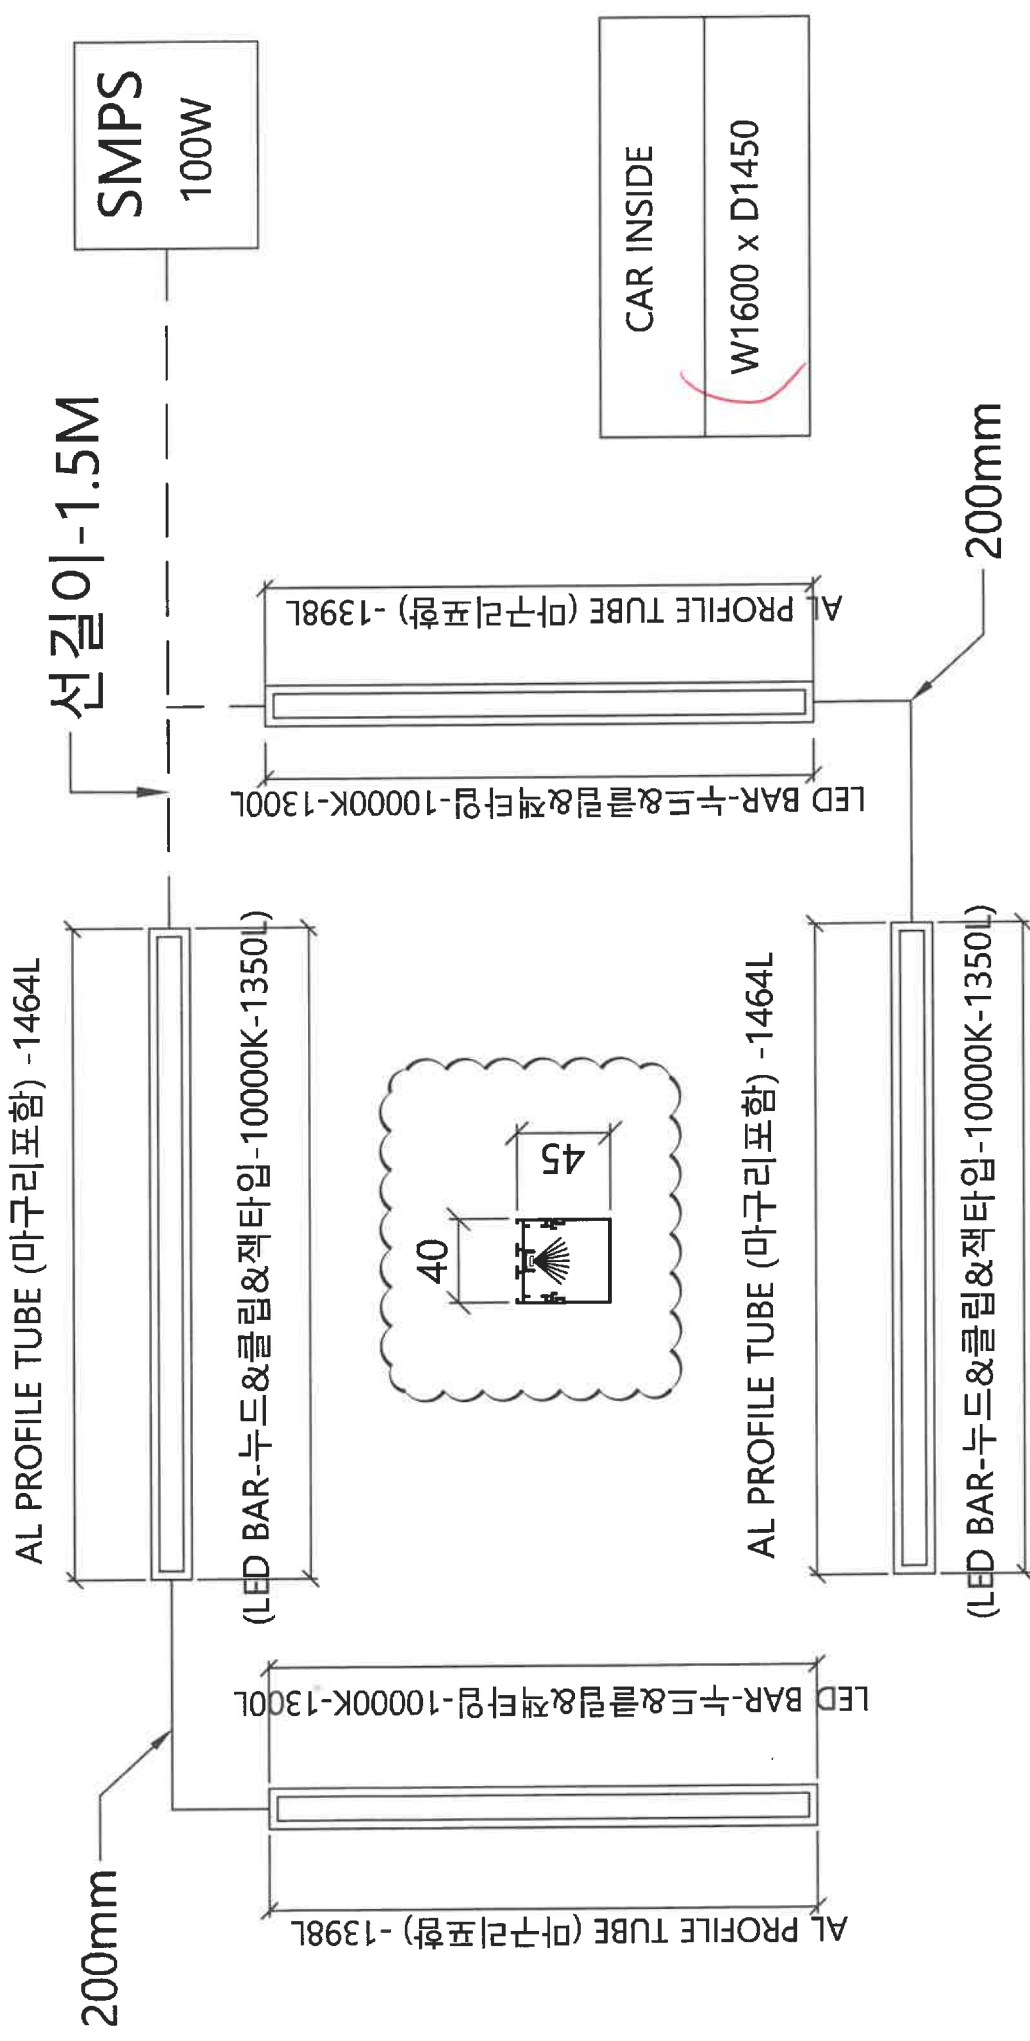


[ 398 - (AL TUBE 길이) ]			
224	LED BAR 고정 센티 - 475L	LED BAR 고정 센티 - 475L	224
49	LED BAR - 10000K (누드&클립&젯타임) = 1300L		49

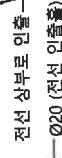

CAR INSIDE


[464 - (AL TUBE 길이)]			
232	LED BAR 고정 센터 - 500L	LED BAR 고정 센터 - 500L	232
O			57
57	LED BAR - 10000K (누드&클립&잭타입) = 1350L		57

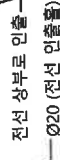[illegible]

NO	DATE	REVISIONS	DEF	CHK	APR
△					
△					
△					
△					

TRACED BY	DRAWN BY	DESIGNED BY	CHECKED BY	REVIEWED BY	APPROVED BY
-----------	----------	-------------	------------	-------------	-------------

<b>SCALE</b>	
<b>DATE</b>	2024-07-10
<b>ANGLE</b>	

PROJECT	판국초등학교/남기필	7	
DTC NAME	Light Case Accessory		
DTC NO	SECRET		

\* 현장명 : 문앤썬-포항 기록면 기초생활거점 - 1(set)

0.75 20442

(등기구업체 : 다운텍)

